


REVISIONS					
REV.	ECO NO.	DESCRIPTION	CHECKED	APPROVED	DATE
A	36-662	INITIAL RELEASE	FJK	RFG	6/21/96
B	36-906	AS BUILT CONFIGURATION			

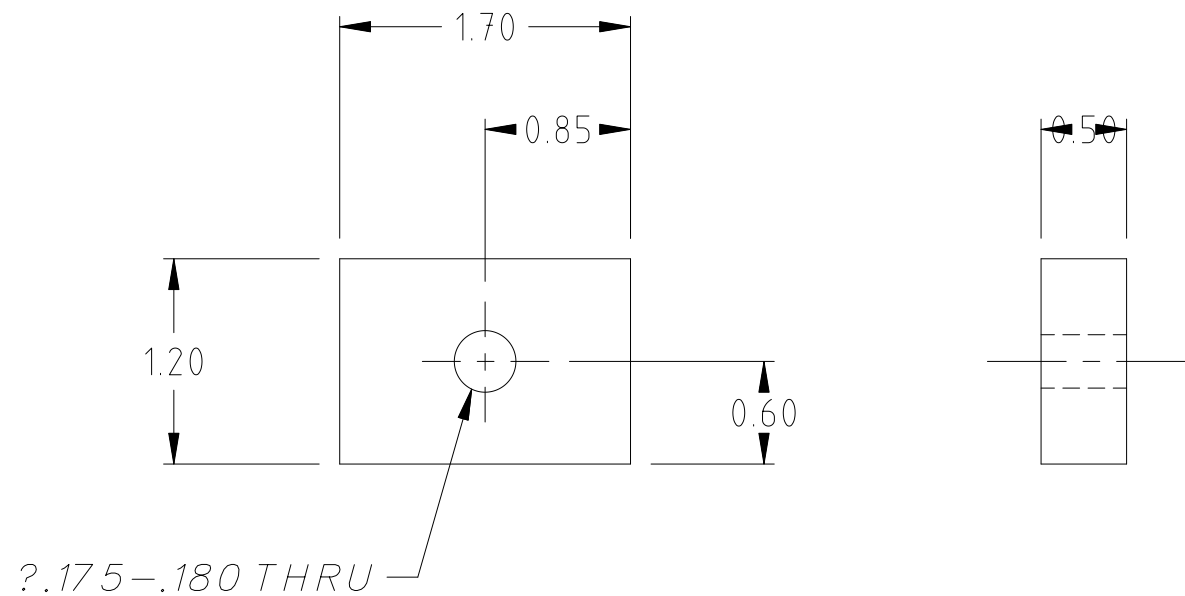

NOTES:

1. REMOVE ALL BURRS AND SHARP EDGES R .010.
2. FINISH: CHEMICAL CONVERSION COAT PER MIL-C-5541, CLASS 3.
3. BAG AND TAG WITH PART NUMBER AND REVISION.

		UNLESS OTHERWISE SPECIFIED DIMENSIONS ARE IN INCHES TOLERANCE: ANGLES ? 1° 3 PLACE DECIMALS ? .005 2 PLACE DECIMALS ? .01	NAME	DATE	MASSACHUSETTS INSTITUTE OF TECHNOLOGY CENTER FOR SPACE RESEARCH CAMBRIDGE, MA 02139				
			DRAWN	M. LYONS	10 JUN 96	SPACER, CABLE MOUNT			
			CHECKED	F. Kasparian	6/21/96				
		MATERIAL	APPROVED	DATE	SIZE CAGE CODE DWG. NO. REV.				
36-30200 ACIS		ALUMINUM 6061-T6	R. Goeke	6/21/96					
NEXT ASSEMBLY USED ON			RELEASED	D. Gage	6/21/96	B	80230	36-30238	B
APPLICATION			WEIGHT				SCALE 2:1		SHEET 1 OF 1